© Jones Edmunds 2234

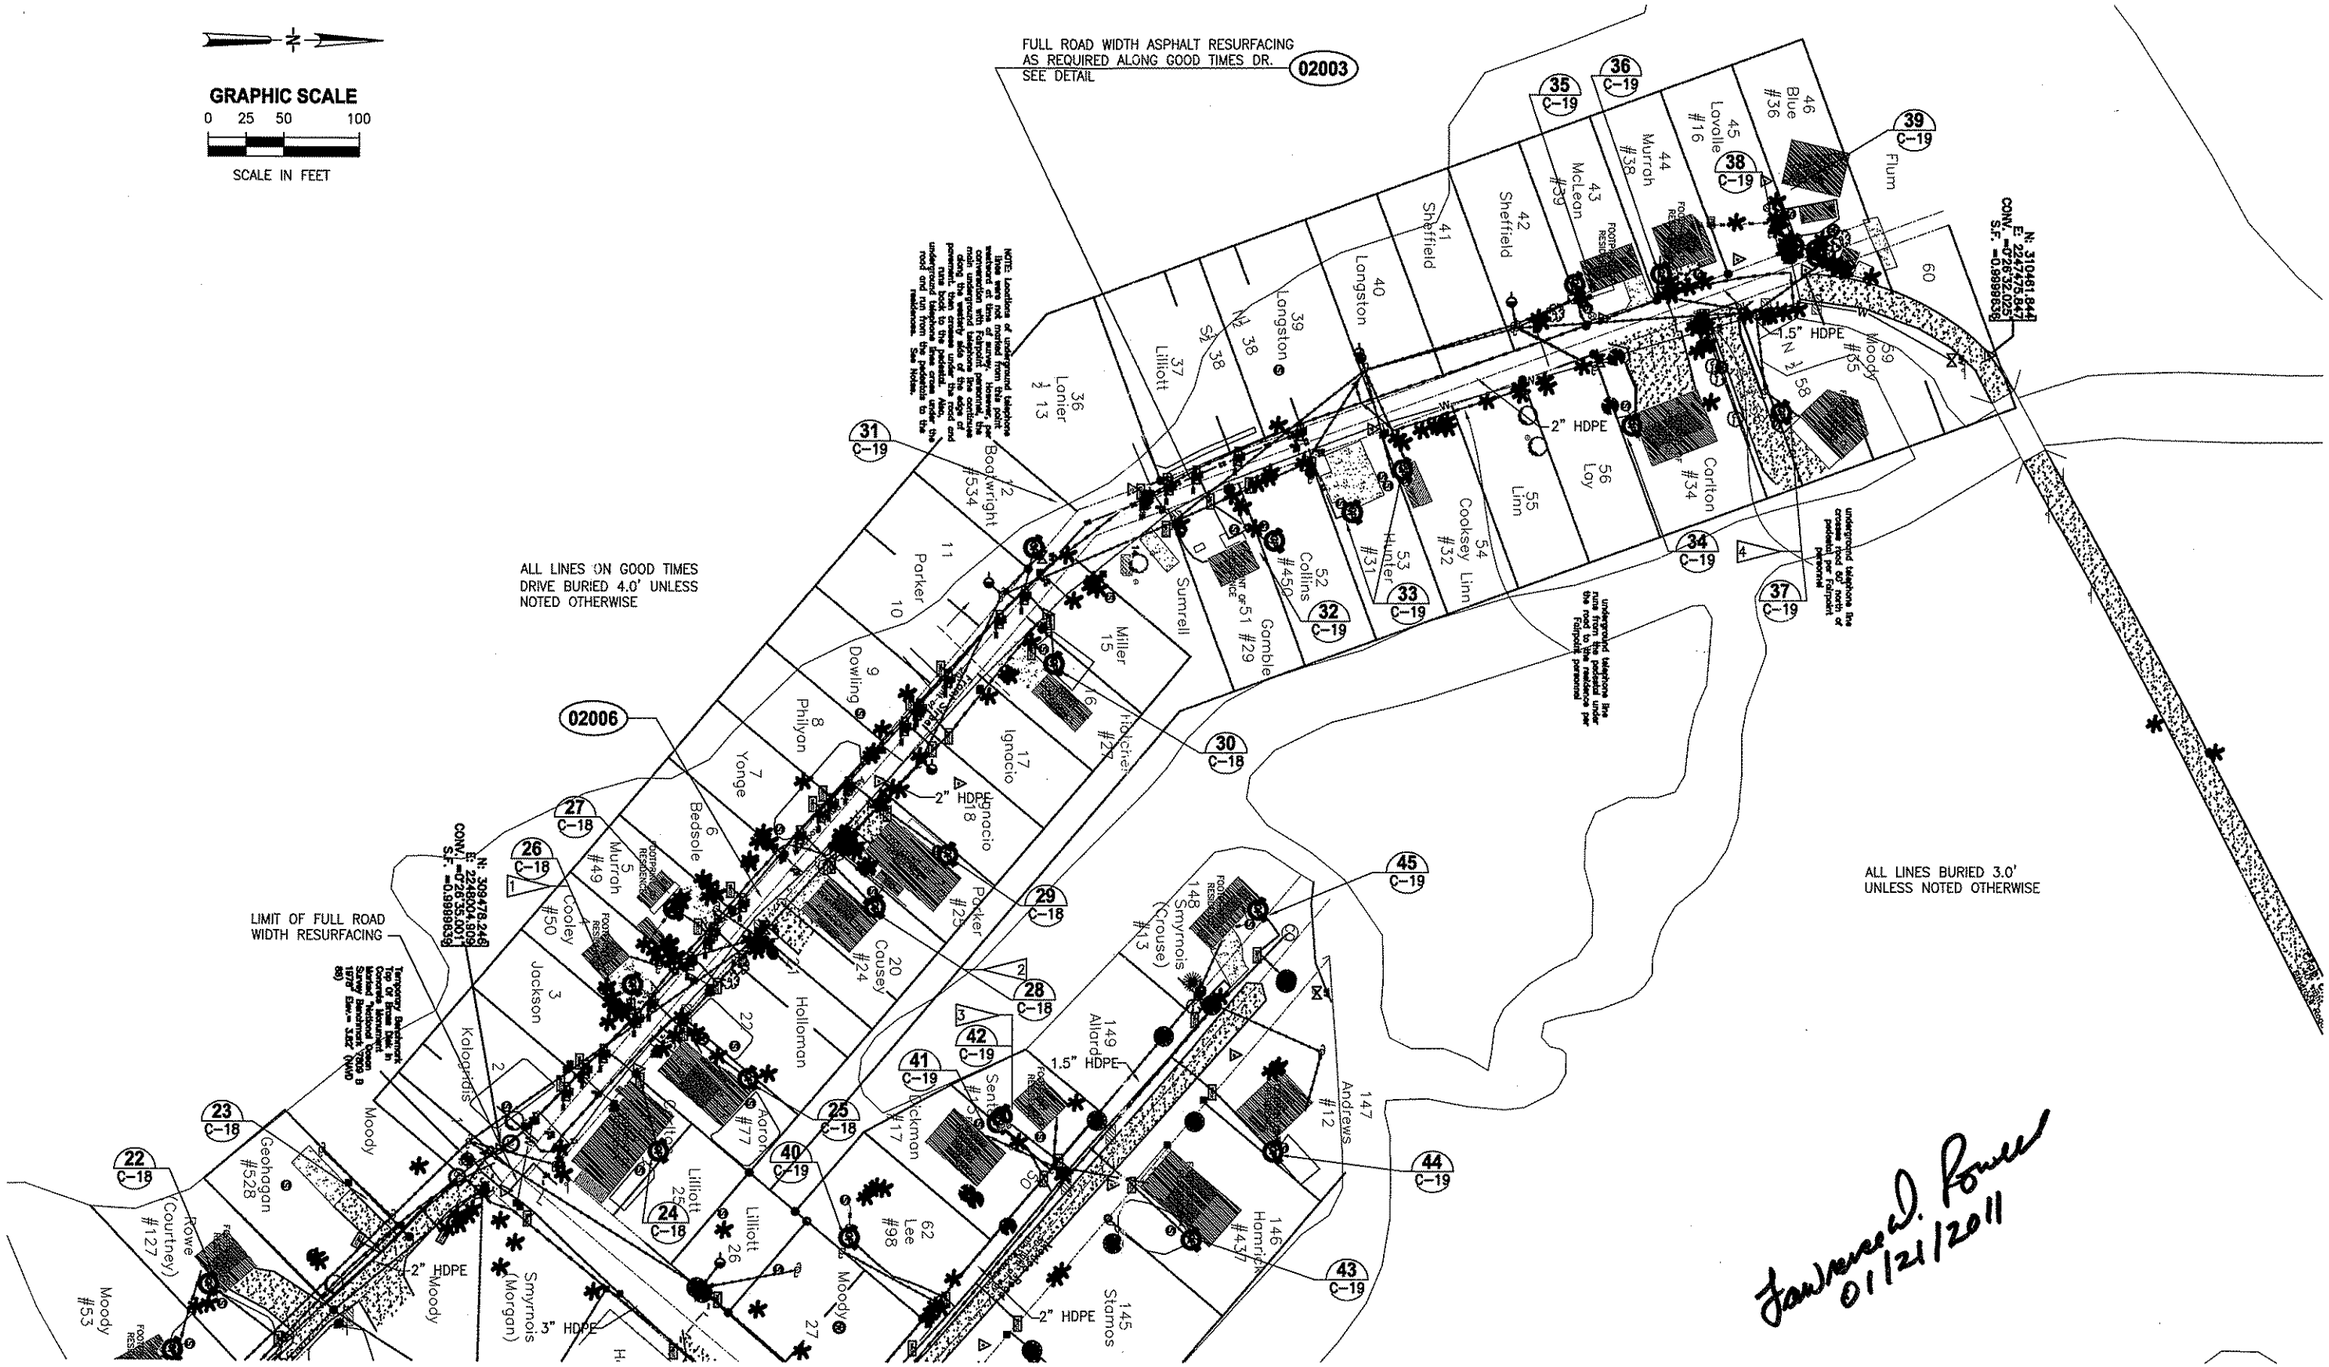

LTR.	DATE	REVISIONS	BY	APPRD.
"A"	12/21/10	As Built Dekle and Boggy Bay	LDR	LDR
"B"	01/10/11	As Built Dark Island	LDR	LDR
"C"	01/21/11	As Built GOOD TIMES DRIVE (WATER LINES)	LDR	LDR

DESIGNED RBEST
DRAWN GOLEARY
CHECKED JHORVATH

JONES EDMUNDS
730 NE WALDO ROAD, GAINESVILLE, FLORIDA 32641 / (352) 377-5821

TAYLOR COASTAL CENTRALIZED WASTEWATER SYSTEM - PHASE II
TAYLOR COUNTY, FL

SANITARY SEWER PLAN

CERTIFICATE OF AUTHORIZATION #1841
APPROVED BY
JOHN H HORVATH
P.E. #47093

DATE 01/10/11
SCALE AS NOTED
PROJECT NO. 20450-002-02
DWG. NO. C-3